


EXISTING SUBSURFACE DRAINAGE SYSTEM RECORD PLAN

THREE LAKES SUBDIVISION

PREPARED FOR KANE CO. DEPT. OF WATER RESOURCES

SECTION NO. 6, ST. CHARLES TWP., KANE CO., IL.

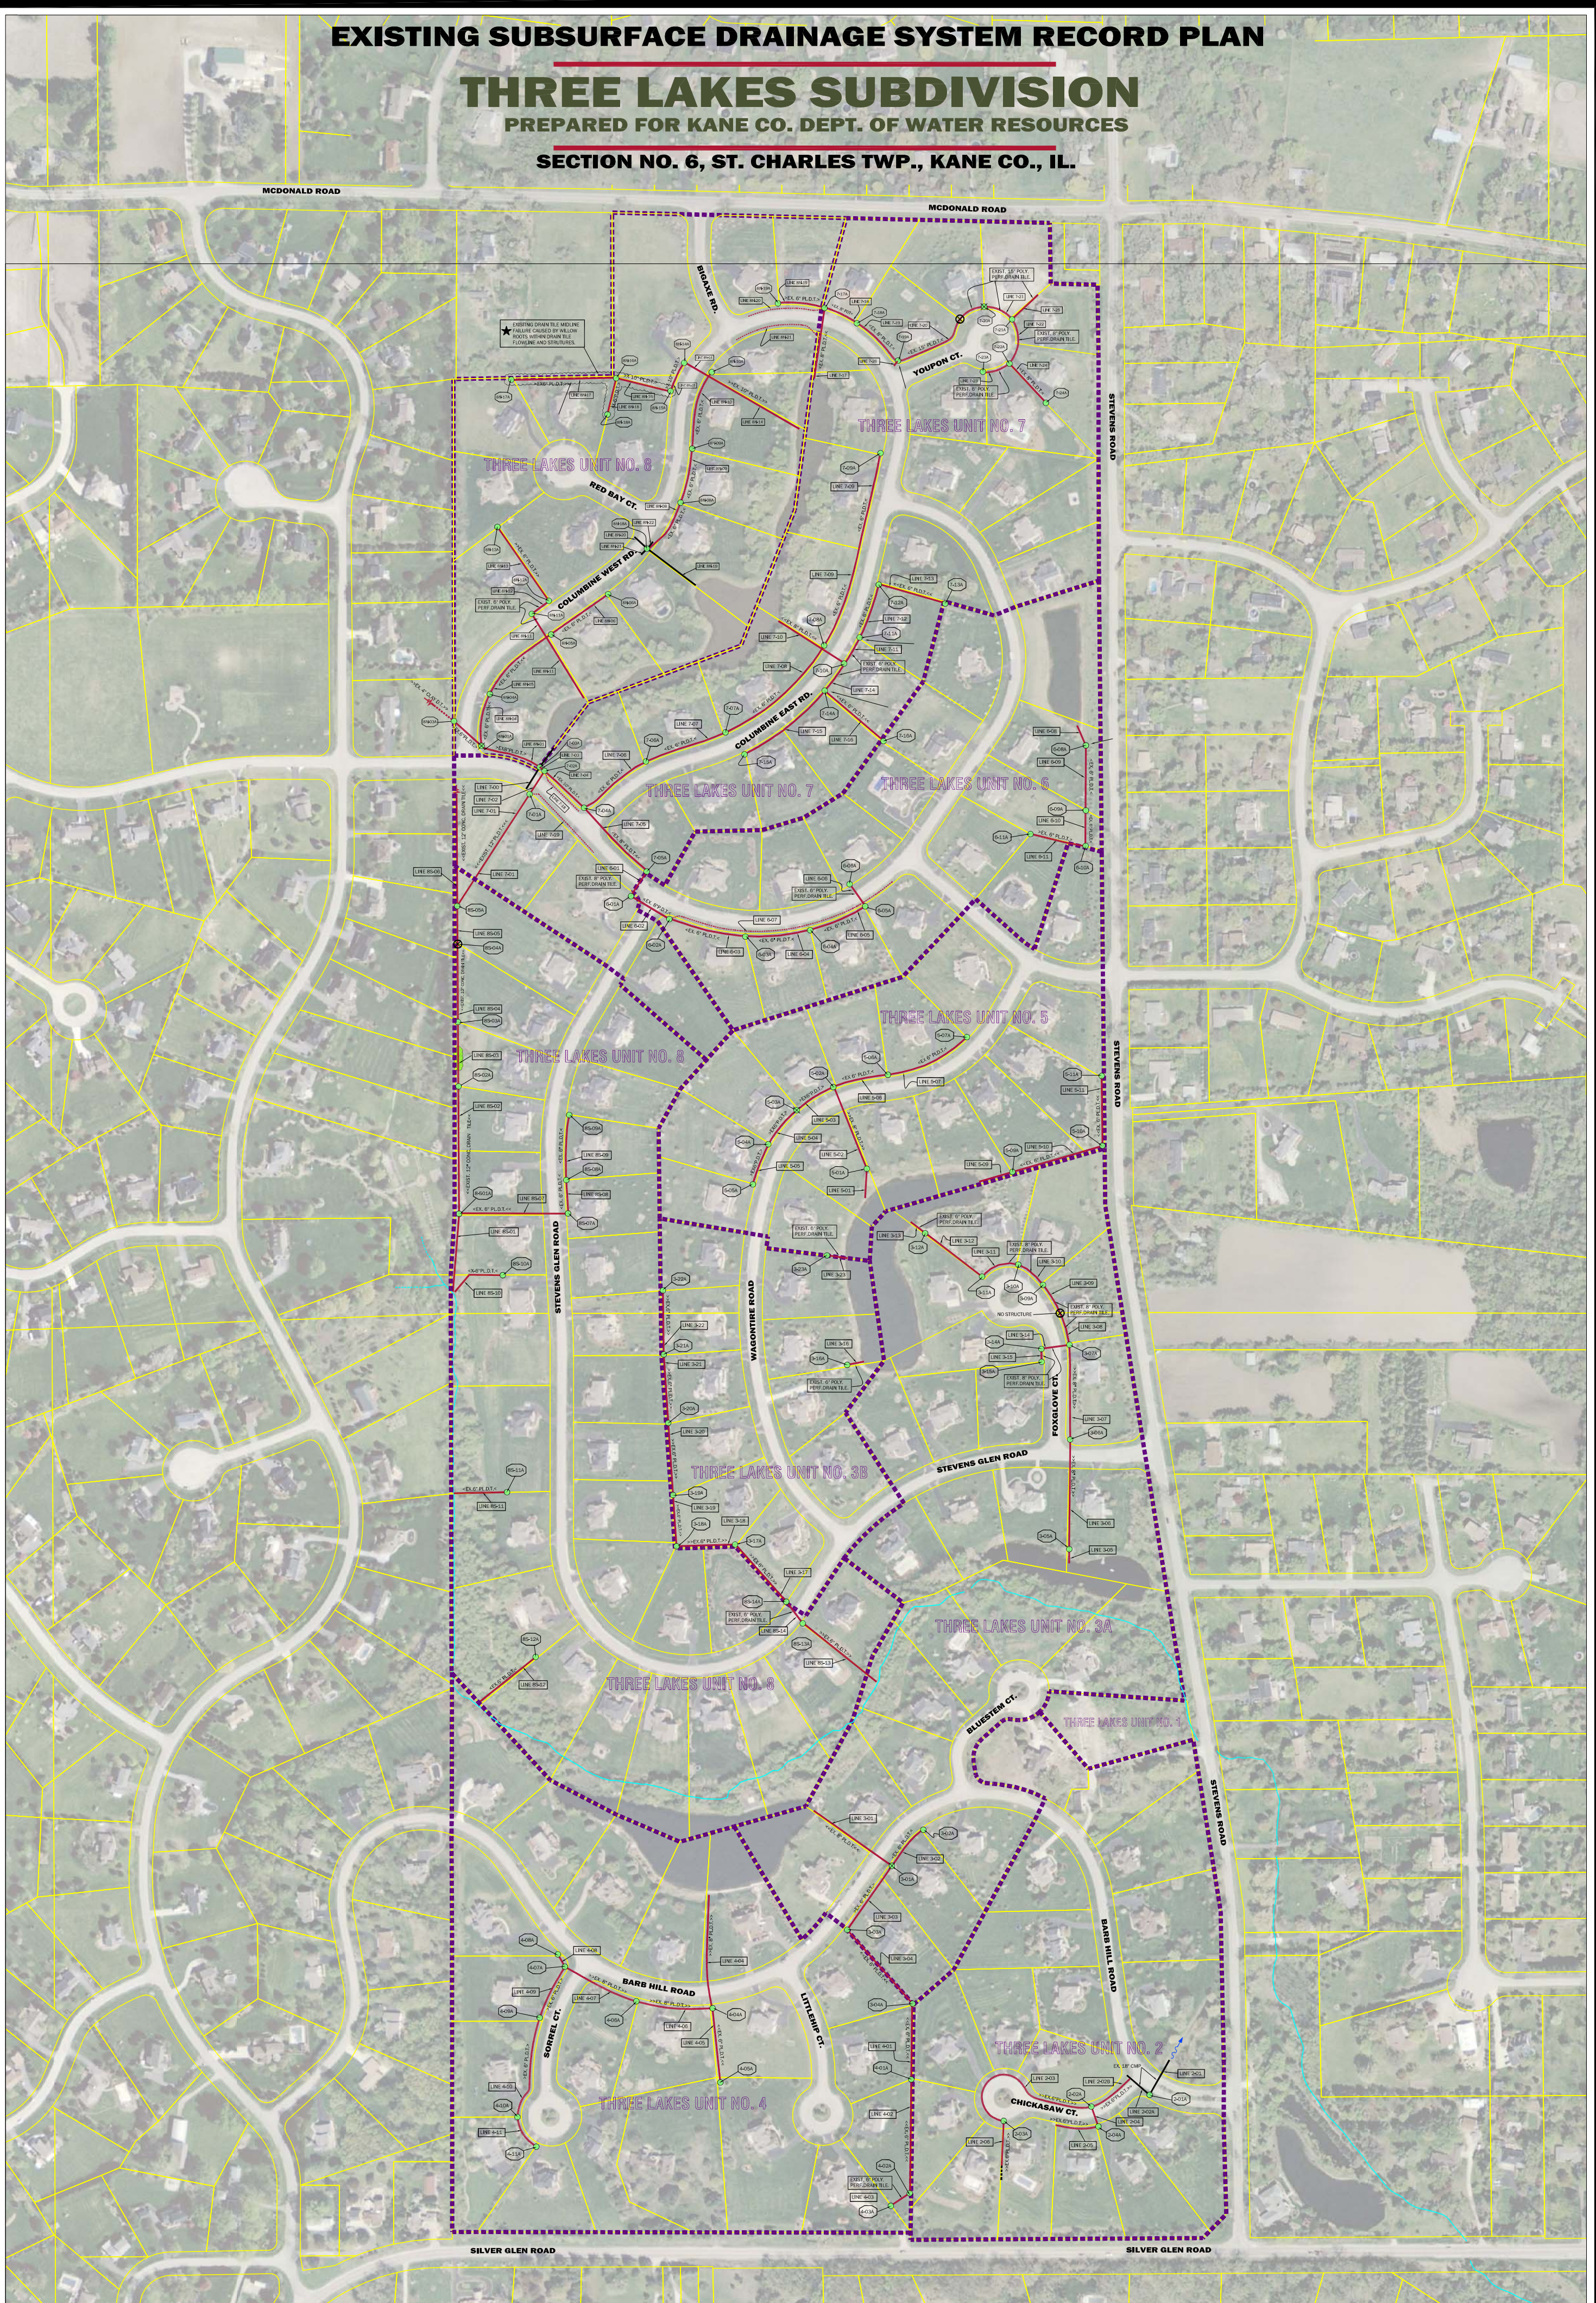

PROJECT CLIENT:
KANE CO. DEPT. OF WATER RESOURCES
SCOTT HAJEK, P.E., PROJECT MANAGER
 719 BATAVIA AVENUE, GENEVA, IL., 60134

APPROVED BY AND DATE:
 TOM HUDDLESTON 4/10/09
 ACKNOWLEDGMENTS:
 HUDDLESTON DRAINAGE MAPPING SYSTEM
 DRAWN BY AND DATE:
 TOM HUDDLESTON 4/10/09

PROJECT DATE:
 4/10/09
 FIELD FILE NO.:

DATE: 8/29/09 BY: TLH DESCRIPTION: FIELD INSPECT SYSTEM
 REVISIONS:
 WEATHER CONDITIONS: SUNNY/ WARM - 25o
 DRAWING NO. 4-14-6 DRAWING SCALE: 1" TO 200' SHEET NO. ONE OF ONE



THREE LAKES SUBDIVISION
 EXISTING SUBSURFACE DRAINAGE
HUDDLESTON McBRIDE
 LAND DRAINAGE SERVICES
 ROCKFELLER, IL. 815-942-4007 ST. CHARLES, IL. 63043-9787